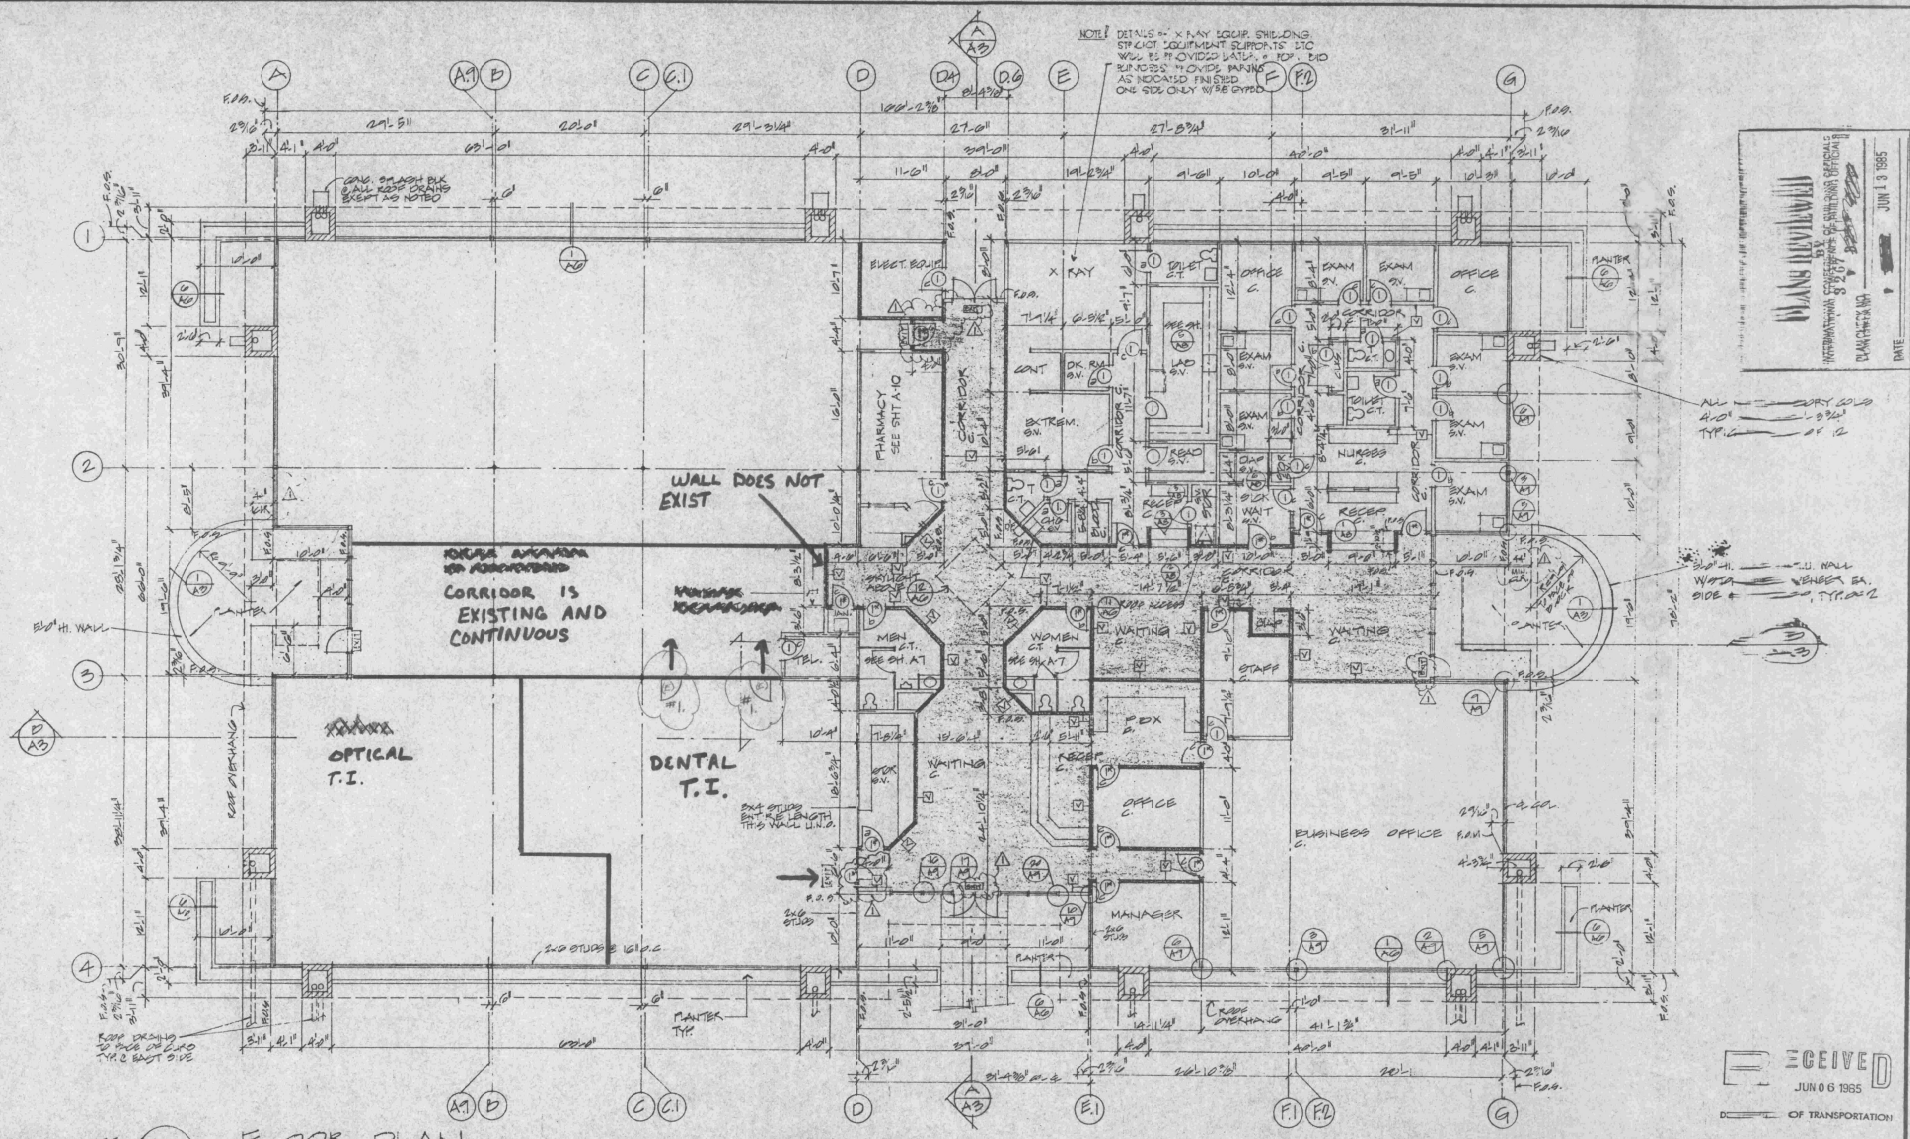

REF. NORTH

FLOOR PLAN

SCALE: 1/8" = 1'-0"

DOOR HARDWARE

'LOCKWOOD' 900 SERIES, US 26 D FINISH

a) ALL PRIVATE TOILETS — 932
b) ALL EXAM ROOMS — 931
c) ALL OFFICES & STORAGE — 930
ALL OTHERS — 931

5. ALL SHELVING IN ALL STORAGE ROOMS TO BE 18" WIDE, 16" APART

NOTES:

1. ALL INTERIOR DOORS 3'-0" x 7'-0" x 1 3/4", 20-10 CORE, PAINT GRADE DOORS MARKED * TO BE 20 MIN. FIRE RATED, TIGHT-FITTING, SMOKE & DRAFT-CONTROL ASSEMBLIES W/ CLOSERS. FINISH W/ DUNN EDWARDS DECORA SEMI-GLOSS W-200 2 COATS (TYP)
2. ALL WALLS TO BE 2 COATS DUNN EDWARDS DECORAL VINYL ACRYLIC PAINT EXCEPT AS MARKED ▽ WHICH ARE TO BE VICKTEX TYPE I STAR DUST 16 OZ VINYL W/ FLAME SPREAD INDEX CLASS I 0-25 · FLR TO CLG · (3 COLORS)
3. FLOOR FINISHES
   C.T. = THIN SET CERAMIC TILE
   C. = CARPET 'STRATON ENCOMPASS' OR EQUAL (3 COLORS)
   S.V. = SHEET VINYL - ARMSTRONG 'SERAGLIO' OR EQUAL
   ALL BASES TO BE 4" TOP SET 'BURKE' OR EQUAL
4. U.N.O. DIMENSIONS ARE TO ℄ OF STUDS.

LEGEND

INDICATES 1 HR WALL
GYP. BD @ UNDERSIDE
PER (A6) 2x4 STUDS @ 16" — N.O.
INTERIOR WALLS: 2x4 @ 16" O.C. U.N.O.
EXTERIOR WALLS: 2x6 @ 16" O.C. U.N.O.
TYPE 'X' JOISTS

8. ALL STOREFRONT GLAZING SHALL BE "SHIPPED GLASS"
6. ALL EXIT GLASS DOORS SHALL BE SO MARKED THAT THEY ARE READILY DISTINGUISHABLE FROM THE ADJACENT CONSTRUCTION


PLANS REVIEWED
INFORMATION CONFORMS TO BUILDING OFFICIALS
BY
PLAN CHECK NO.

NO	DATE	REVISION	BY
1	6-5-86	PLAN CHECK REVISION	T.E.

SHEET TITLE: FLOOR PLAN
JOB NAME: SCRIPPS CLINIC SAN JACINTO & ROBERT BOYLAN BUILDING
STUDIES 4-D
DRAWN E.E.
CHECKED T.D.
DATE 2-25-85

James P. Owen Architecture Inc.
12425, Rancho Bernardo Road
San Diego, California 92128
Telephone (619) 485-6936

SHEET A2.0
OF
FILE CODE 1098